

SEPTIC SYSTEM CONSTRUCTION JOB CARD

SYSTEM ADDRESS: _____

DESIGNER: _____ PHONE NUMBER: _____

INSTALLER: _____ PHONE NUMBER: _____

This card is to be kept on site during construction and returned to the Board of Health (BOH) upon completion of all work. A Certificate of Compliance will not be issued without receipt of this card.

Contractor is responsible for scheduling all required inspections with the DESIGN ENGINEER and BOH. System shall not be backfilled without required inspection signoffs.

If checked, the following special conditions are required prior to construction:

Contractor to contact designer prior to start of work

Contractor to schedule a pre-construction meeting with designer and BOH

As a minimum the following inspections are required. Additional inspections may be added based on the pre-construction meeting. Inspectors to initial, date and note if a re-inspection of the work is required.

INSPECTIONS	DESIGNER	HEALTH AGENT	RE-INSPECTION?
Bottom of leach system			yes no
Stone under septic tank			yes no
Septic tank			yes no
Distribution Box			yes no
Pump/Stone/floats & Alarms			yes no
Piping/Leaching area			yes no
Vents/Inspection Port			yes no
Final Grades/Breakout Impervious barrier Retaining wall			yes no

Aggregate (1-1/2" Stone) obtained from: _____ Date: _____

Fill obtained from: _____ Date: _____

(Per Title 5 septic sand - 310 CMR 15.255 (3))


DISPOSAL SYSTEM INSTALLER CERTIFICATION

I certify that the on-site sewage disposal system installed on _____ for the property located at _____ Plainville, MA has been constructed in compliance with 310 CMR 15.000, the approved design plans; and all local requirements.

Signature

Date

PROVIDE AS-BUILT SKETCH WITH LOCATION TIES

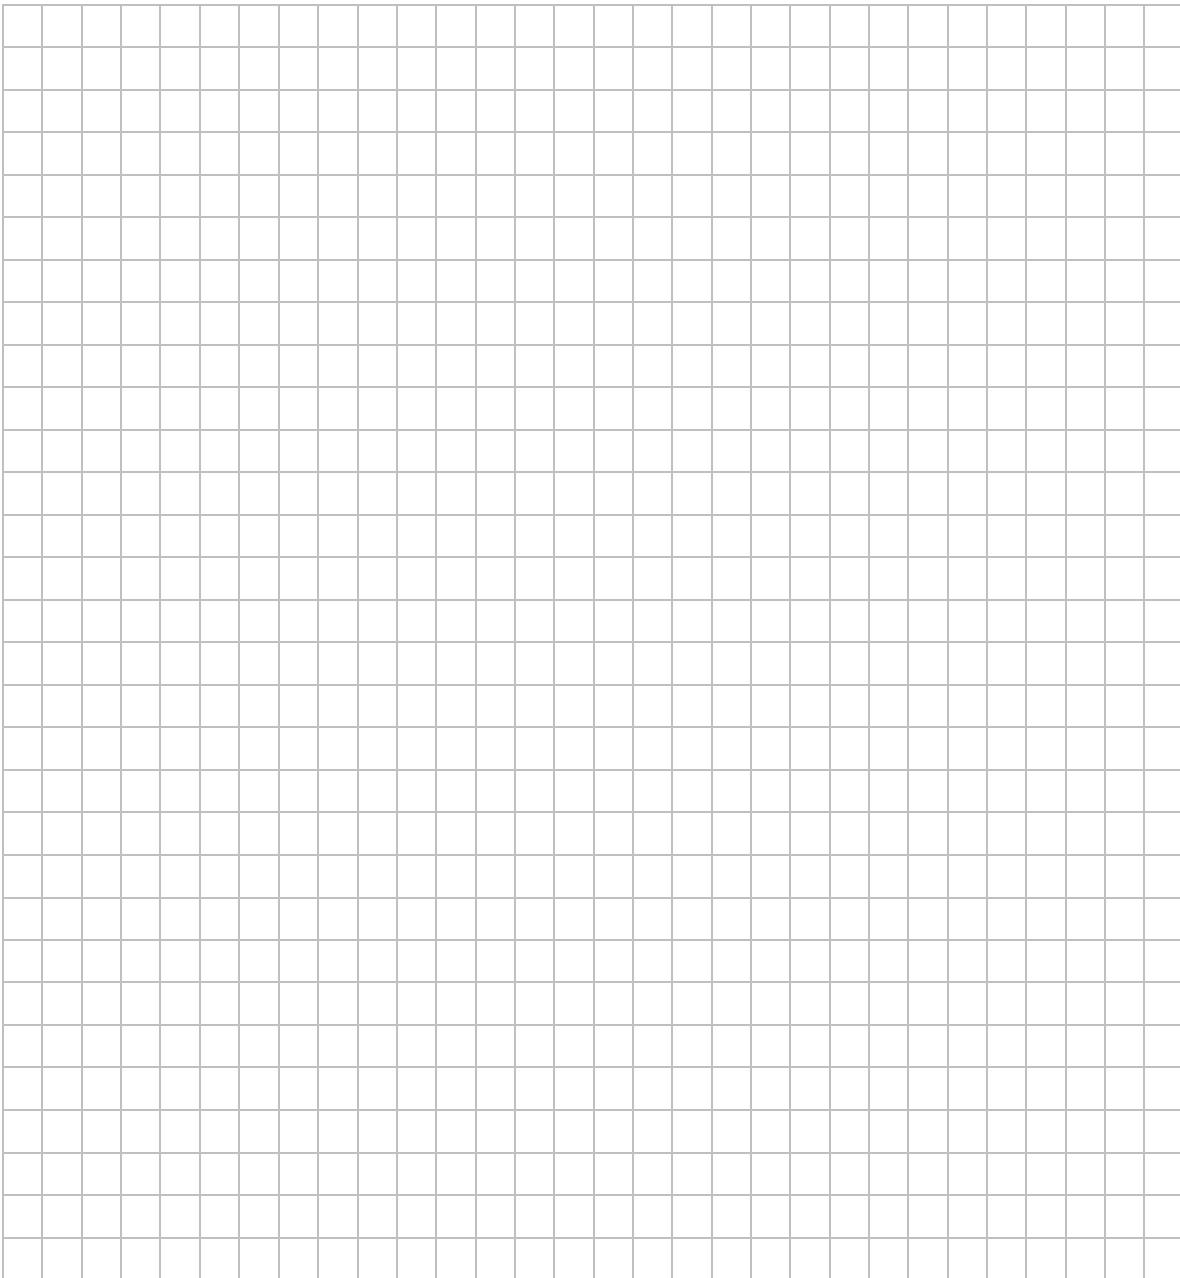

TO BE POSTED

MAINTENANCE

THE BOARD OF HEALTH RECOMMENDS THAT THE SEPTIC TANK BE INSPECTED ANNUALLY AND PUMPED AND MAINTAINED ON A REGULAR BASIS (Usually every 2-3 Years).

THE SEPTIC TANK IS EQUIPPED WITH AN OUTLET TEE FILTER THAT REQUIRES REGULAR CLEANING BY A QUALIFIED LICENSED SEPTAGE HAULER

A GARBAGE GRINDER IS NOT ALLOWED IN THE DWELLING

(FOR BOH USE)